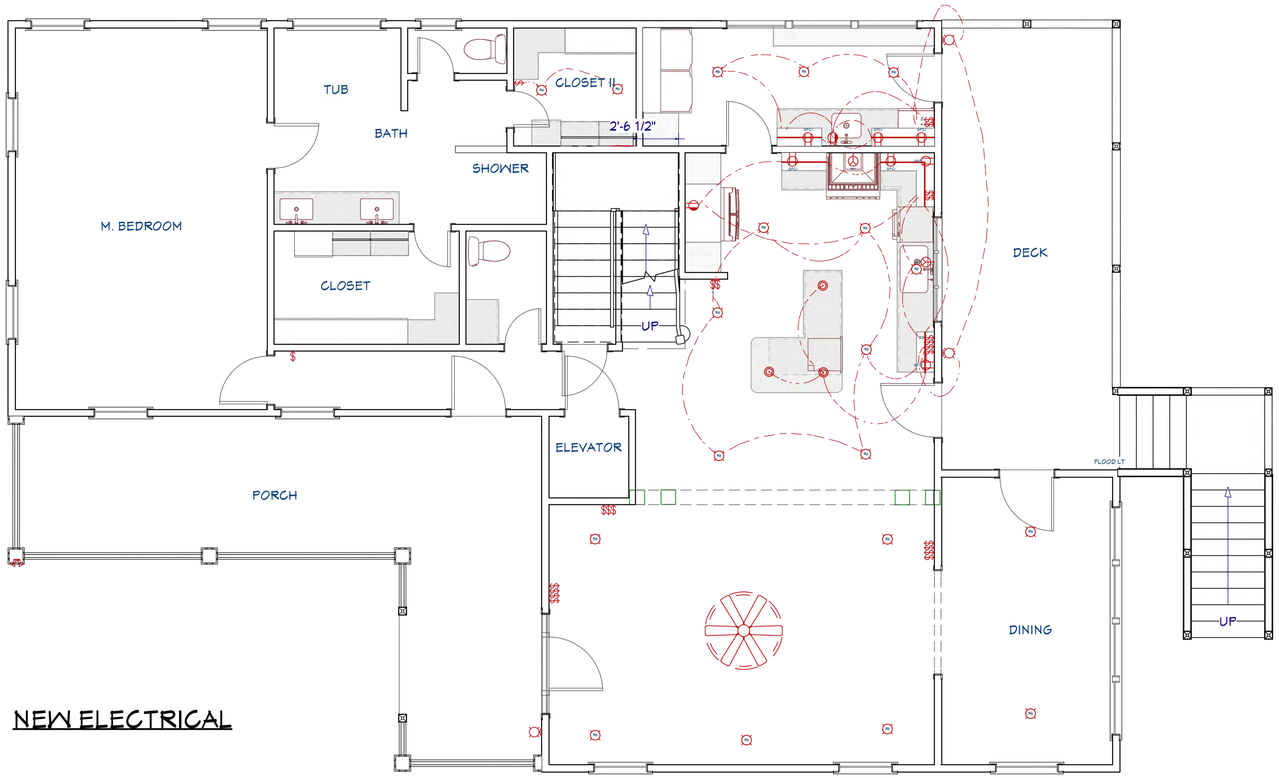

NEW ELECTRICAL

ELECTRICAL LEGEND

LIGHTING

- R4 / R / R — RECESSED 4" & 6" CANS / WET RATED
- PENDANTS / WALL LAMP / SCONCE
- UNDER CABINET LED PUCK / LED STRIP / CEILING LED
- FAN / FAN LIGHT. 200 CFM MIN.
- CEILING FAN W/ LIGHT

SWITCHES / OUTLETS

- $ / $3 / $4 — SWITCH / 3-WAY / 4-WAY
- SB / GFCI / WP — OUTLETS - USB 5V & 120V / 120V WALL & CEILING GFCI / WATER PROOF / 220V
- R / M / DW / GD — APPLIANCE SPECIFIC: REFRIGERATOR / MICROWAVE / DISH WASTER / DISPOSAL
- H / CW / CD / RA — COOK HOOD / WASHER / DRYER / WALL OVEN

OTHER MEP

- C5 / C5/TV / VAC / HS — CAT5 / CAT5 & COAX RG6QS / CENTRAL VAC / HOME SECURITY PANEL
- S / T / G — SMOKE DETECTOR / THERMOSTAT / GAS CONNECTION / DOOR BELL
- SP — SPEAKERS: CEILING MOUNTED. NOTE, USE WALL CONTROLLED VOLUME SWITCH

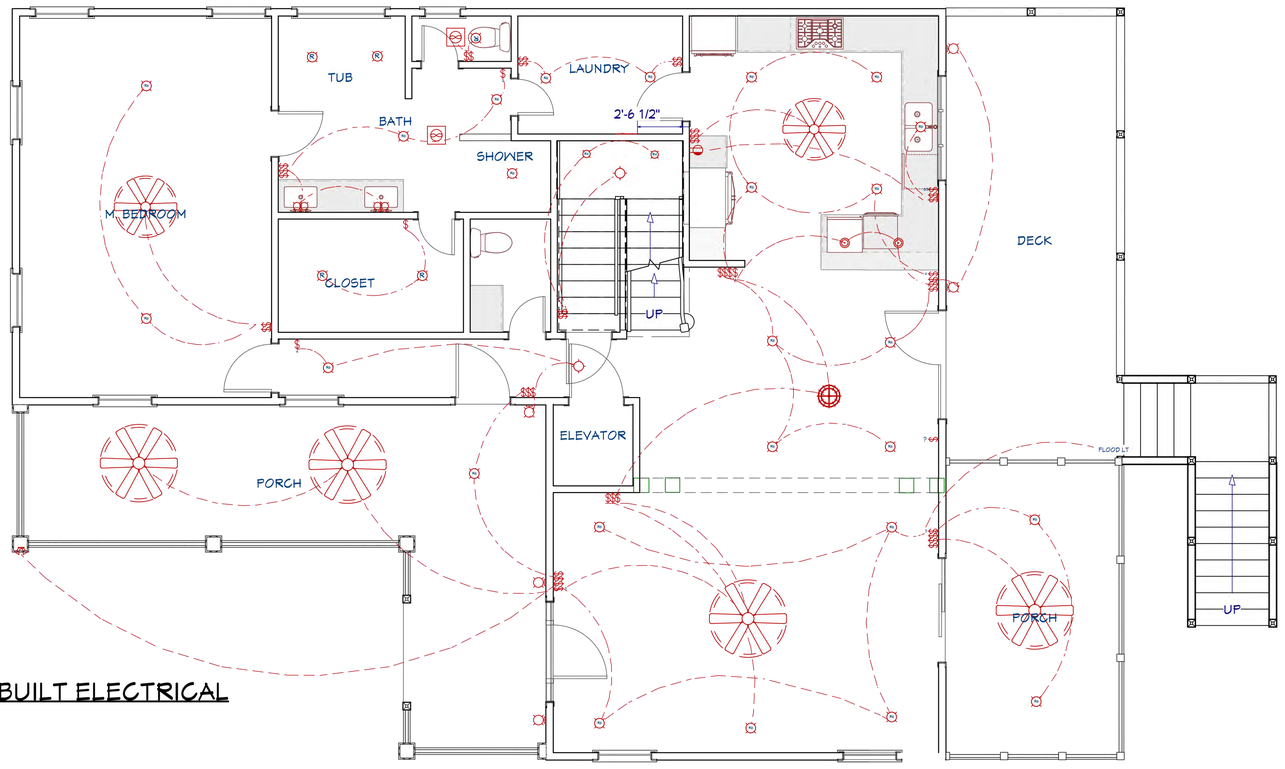

AS-BUILT ELECTRICAL

SHEET NUMBER 8

SCALE @ 24" X 36"

DATE: 8-12-25

DRAWN BY: Michael Pope

ELECTRICAL

© 2025

better... by design
Michael Pope & Mary Gerard, Designers
341 Stinson Dr.
Charleston, SC 29407